

1140 N. PROVIDENCE ROAD
MEDIA, PENNSYLVANIA 19063
TEL: 610.566.7044
FAX: 610.566.3258

ADDENDUM NO.3

Eddystone Borough - Municipal Building Renovations

February 23, 2023

The following are revisions, clarifications, or additions to the contract drawings for the above referenced project:

1. Please see updated Demo drawing to include Removal of sidewalk in the area of new Electrical service entrance
2. The Bid due date will be extended to 2:00 PM, Friday, March 3, 2023
3. Given the longer than usual lead times for some materials the length of time to perform the work will be extended from 270 days to 330 days
4. See attached addendum 3 of electrical changes and updated drawings
- 5) Question: Is the security contractor responsible for electric locks? The door hardware schedule does not include electric locks.?

Answer: Yes, the basis of design for electric locks shall be PDK, electric locks shall be located as designated on the door schedule for FOB locations.

- 6) Question: Is there a spec for the metal lockers? There doesn't seem to be anything called out in the spec sheet & the model number listed in the plans is invalid.

Answer: Basis of design for the lockers is Penco Patriot Duty Lockers, size 24x24x72, with integral channel base, Cremone Turn Handle, Coat hook, Finished end panel, Cell phone/Key tray, color to be selected.

- 7) Question: As no Mechanical Roof Demo Plan is available, please identify what the existing roof material is, any penetrations in the existing roof that need to be infilled, as well as the approx. size and thickness of infill required. It is understood the existing packaged RTUs will be removed but that the supply and return mains are to remain for reuse.

Answer: The Roof plan has been updated to show Approximate locations of existing RTU locations and infill detail for all former openings.

END OF ADDENDUM



Addendum #3

For

Renovations to Municipal Building Eddystone, PA

Project No: 22065

Feb. 22, 2023

The following changes shall become a part of the Contract and shall supersede anything called for previously on the Contract Drawings with which they may be at variance. This Addendum shall be a part of, and attached to, the Contract Documents.

CHANGES TO DRAWINGS

Electrical

E-1 – Electrical Cover Sheet

- a. Updated Drawing Index

E-2 – Electrical Floor Power Plan – New Work

- a. Deleted Service Disconnect Switch on Basement Plan
- b. Added Media Backboard, Quad Receptacles, and Associated Keynote on Basement Plan
- c. Added Telecommunications Conduit on First Floor Plan

E-5 – Electrical Schedules

- d. Revised Panels MP and PP Schedules according to single line and floor plan changes

E-6 – Electrical Single Line Diagram

- a. Clarified ATS switch legs
- b. Revised Wire Sizes feeding ATS Switch and Panel PP
- c. Deleted Service Disconnect Switch
- d. Revised Service Entrance Cable Sizes
- e. Revised Panels MP and PP sizes
- f. Removed Service Size from CT Cabinet

END OF ADDENDUM #3

GENERAL SPECIFICATIONS

- THE DRAWINGS INDICATE A PERFORMANCE SPECIFICATION FOR THE FIRE ALARM SYSTEM. AWARDED CONTRACTOR IS RESPONSIBLE FOR DETAILED DESIGN AND PREPARATION OF SIGNED AND SEALED ENGINEERING DOCUMENTS FOR REVIEW/ APPROVAL FROM OWNERS INSURANCE CARRIER AND LOCAL AUTHORITY HAVING JURISDICTION.
- DRAWINGS ARE DIAGNOSTIC. DETERMINE LOCATIONS OF SYSTEMS AND COMPONENTS IN FIELD. COORDINATE WITH ARCHITECTURAL DRAWINGS AND OTHER TRADES.
- ADDRESS QUESTIONS REGARDING DRAWINGS TO ARCHITECT IN WRITING BEFORE AWARD OF CONTRACT. OTHERWISE, ARCHITECT'S INTERPRETATION OF MEANING AND INTENT OF DRAWINGS SHALL BE FINAL. THE INTENTION IS FOR INSTALLATION OF COMPLETE AND OPERATING SYSTEMS. NOT EVERY COMPONENT REQUIRED IS SHOWN. THE CONTRACTOR SHALL INCLUDE ALL COMPONENTS NORMALLY ASSOCIATED WITH THE PARTICULAR SYSTEM. THE SYSTEM SHALL BE FULLY COMMISSIONED AND SIGNED OFF BY AN OFFICER OF THE RESPECTIVE CONTRACTOR.
- GIVE NOTICES, FILE PLANS, OBTAIN PERMITS AND LICENSES, PAY FEES AND BACK CHARGES, AND OBTAIN NECESSARY APPROVALS FROM AUTHORITIES THAT HAVE JURISDICTION AS REQUIRED TO PERFORM WORK IN ACCORDANCE WITH ALL LOCAL REQUIREMENTS AND WITH THE DESIGN DOCUMENTS PRIOR TO COMMENCING WORK. CONTRACTOR SHALL SUBMIT SHOP DRAWINGS AND EQUIPMENT DATA FOR MATERIALS AND EQUIPMENT TO THE ARCHITECT FOR REVIEW AND APPROVAL. MATERIALS AND EQUIPMENT SHALL NOT BE INSTALLED BEFORE SHOP DRAWINGS ARE REVIEWED AND APPROVED. SCHEDULE AT LEAST TEN WORKING DAYS, EXCLUSIVE OF TRANSMITTAL TIME, FOR SUBMITTAL REVIEW SHALL BE ALLOWED.
- MATERIALS AND EQUIPMENT SHALL BE LISTED BY UNDERWRITERS LABORATORIES (UL) AND APPROVED BY ASME AND AGA FOR INTENDED SERVICE.
- THE CONTRACTOR SHALL BE SOLELY RESPONSIBLE FOR CONSTRUCTION MEANS, METHODS, TECHNIQUES, SEQUENCES AND PROCEDURES REQUIRED FOR SAFE EXECUTION AND COMPLETION OF WORK, AND FOR INITIATING, MAINTAINING AND SUPERVISING ALL SAFETY PRECAUTIONS AND PROGRAMS IN CONNECTION WITH THE WORK.
- COORDINATE WORK OF THIS SECTION WITH THAT OF OTHER SECTIONS.
- ALL MATERIALS, EQUIPMENT AND METHOD OF INSTALLATION SHALL BE ACCORDANCE WITH THE STANDARDS, REGULATIONS, CODES, ORDINANCES, AND LAW OF LOCAL, STATE, AND FEDERAL GOVERNMENTS, AND OTHER AUTHORITIES THAT HAVE LAWFUL JURISDICTION.
- IT SHALL BE THE RESPONSIBILITY OF THIS CONTRACTOR TO COORDINATE HIS WORK WITH THAT OF ALL OTHER TRADES, INCLUDING (BUT NOT LIMITED TO), ELECTRICAL, HVAC, SPRINKLER, FIRE PROTECTION, STRUCTURAL AND GENERAL ARCHITECTURE. OFFSETS IN PIPING AND OFFSETS AROUND OBSTRUCTIONS SHALL BE PROVIDED AT NO ADDITIONAL COST TO THE OWNER.
- DEVIATION FROM CONTRACT DOCUMENTS, OR PROPOSED SUBSTITUTION OF MATERIALS OR EQUIPMENT FOR THOSE SPECIFIED, SHALL BE REQUESTED IN SEPARATE LETTER, WHETHER DEVIATIONS ARE DUE TO FIELD CONDITIONS, STANDARD SHOP PRACTICE OR OTHER CAUSE.
- EACH CONTRACTOR IS RESPONSIBLE FOR THE CUTTING AND PATCHING REQUIRED FOR THE INSTALLATION OF HIS NEW WORK. CUTTING AND PATCHING SHALL BE COMPLETED IN A NEAT AND WORKMANLIKE MANNER. PATCHING MATERIALS SHALL MATCH EXISTING MATERIALS TO THE GREATEST EXTENT POSSIBLE. PROVIDE TOUCH-UP TO MATCH EXISTING SURROUNDING AREAS OF CUTTING AND PATCHING WORK.
- CONTRACTOR SHALL COORDINATE ITS RESPECTIVE CEILING MOUNTED EQUIPMENT WITH OTHER TRADE CONTRACTORS PRIOR TO INSTALLATION TO AVOID CONFLICTS.
- ANY DEMOLITION SHALL BE COORDINATED WITH OWNER, ARCHITECT, G.C. AND ENGINEER. ALL DEBRIS SHALL BE CLEANED UP AND REMOVED FROM THE SITE BY THE END OF THE DAY. PRIOR TO DISPOSAL OF EQUIPMENT AND MATERIALS, TURN OVER TO THE OWNER ANY REMOVED EQUIPMENT AND MATERIALS PER OWNERS REQUEST.
- WORK SHALL BE EXECUTED IN A WORKMANLIKE MANNER AND SHALL PRESENT NEAT, RECTILINEAR APPEARANCE WHEN COMPLETED. MAINTAIN MAXIMUM HEAD ROOM AT ALL TIMES. DO NOT RUN PIPES, DUCTS, AND CONDUIT EXPOSED UNLESS SHOWN AND NOTED TO BE EXPOSED ON DRAWINGS. MATERIALS AND EQUIPMENT SHALL BE NEW AND INSTALLED ACCORDING TO MANUFACTURERS INSTRUCTIONS AND RECOMMENDATIONS, SO THAT COMPLETED INSTALLATION SHALL OPERATE SAFELY AND EFFICIENTLY.
- COORDINATE ROOF PENETRATIONS WITH WORK OF OTHER SECTIONS AND WITH FLASHING REQUIREMENTS.
- ANY INTERFERENCE SHALL BE BROUGHT TO THE ATTENTION OF THE OWNERS REPRESENTATIVE, AND SHALL BE RESOLVED PRIOR TO THE INSTALLATION OF THE WORK INVOLVED.
- ALL MATERIALS AND EQUIPMENT SHALL BE NEW UNLESS NOTED OTHERWISE.
- MANUFACTURERS' MODEL NUMBERS ARE SPECIFIED SOLELY TO ESTABLISH STANDARDS OF QUALITY FOR PERFORMANCE AND MATERIALS.
- SUBSTITUTED PRODUCTS SUBMITTED AND APPROVED FOR USE THAT NECESSITATE CHANGES TO THE WORK OF OTHER TRADES OF CONTRACT SHALL BE COORDINATED AND ARRANGED BY THE CONTRACTOR WHO SUBMITTED THE SUBSTITUTION WITHOUT ADDITIONAL COST TO THE OWNER.
- PRODUCT INSTALLATION SHALL ADHERE TO MANUFACTURERS RECOMMENDATIONS.
- EACH RESPECTIVE CONTRACTOR SHALL PROVIDE PROPER ACCESS TO EQUIPMENT THAT REQUIRES INSPECTION, REPLACEMENT OR REPAIR. ACCESS PANELS SHALL BE A MINIMUM OF 12" X 12" OR AS NEEDED FOR APPROPRIATE ACCESS, TO BE SUPPLIED TO GENERAL CONTRACTOR FOR INSTALLATION.
- CONTRACTOR SHALL COORDINATE ELECTRICAL CHARACTERISTICS AND REQUIREMENTS OF ALL APPLICABLE EQUIPMENT WITH THE ELECTRICAL CONTRACTOR.
- ALL EQUIPMENT, PIPING, INSULATION, ETC., INSTALLED IN HVAC PLenums SPACES SHALL MEET CODE REQUIREMENTS FOR SMOKE AND COMBUSTIBILITY.
- AS WORK PROGRESSES AND FOR DURATION OF CONTRACT, MAINTAIN COMPLETE SET OF PRINTS OF CONTRACT DRAWINGS AT JOB SITE AT ALL TIMES. RECORD WORK COMPLETED AND ALL CHANGES FROM ORIGINAL CONTRACT DRAWINGS CLEARLY AND ACCURATELY INCLUDING WORK INSTALLED AS A MODIFICATION OR ADDITION TO THE ORIGINAL DESIGN. TURN OVER ALL OPERATING MANUALS, MAINTENANCE MANUALS, AND "AS BUILT" DRAWINGS TO OWNER AT CONCLUSION OF CONSTRUCTION. DO NOT SUPPORT EQUIPMENT FROM SUSPENDED CEILING. SUPPORT ALL EQUIPMENT AND PIPING FROM BUILDING STRUCTURE TO PROVIDE A VIBRATION FREE INSTALLATION. NOTIFY ARCHITECT AND STRUCTURAL ENGINEER OF ALL WEIGHING AND METHODS OF SUPPORT.
- RUN PIPING/WIRING CONCEALED, UNLESS SPECIFIED OTHERWISE, AND CLEAR OF CEILING INSERTS.
- ANY REFERENCE TO ELECTRICAL, PLUMBING AND HVAC CONTRACTORS, NOTED ON THESE DRAWINGS OR STATED IN THE SPECIFICATIONS SHALL NOT BE MISCONSTRUED AS AN INTENTION TO DERIVE SEPARATE CONTRACTS FOR THE RESPECTIVE WORK. THE GENERAL CONTRACTOR SHALL COORDINATE AND PROVIDE A COMPLETE BUILDING WITH COMPLETE MECHANICAL AND ELECTRICAL SYSTEMS, REGARDLESS OF ANY SPECIFICATION REFERENCES TO OTHER CONTRACTORS.
- GUARANTEE WORK OF THIS CONTRACTOR IN WRITING FOR ONE YEAR FROM THE DATE OF OWNERS ACCEPTANCE OF CERTIFICATE OF SUBSTANTIAL COMPLETION. PROMPTLY REPAIR OR REPLACE DEFECTIVE MATERIALS, EQUIPMENT, WORKMANSHIP AND INSTALLATIONS THAT DEVELOP DEFECTS WITHIN THIS PERIOD. PROMPTLY AND TO OWNERS SATISFACTION, CORRECT DAMAGE CAUSED IN MAKING NECESSARY REPAIRS AND REPLACEMENTS UNDER GUARANTEED AT NO ADDITIONAL COST TO OWNER. SUBMIT GUARANTEE TO ARCHITECT BEFORE FINAL PAYMENT. STATEMENT OF GUARANTEE REQUIREMENTS SHALL NOT BE INTERRUPTED TO LIMIT OWNERS RIGHTS UNDER LAW AND THIS CONTRACT.


CODE SUMMARY

MUNICIPALITY	EDDYSTONE BOROUGH, PA
USE AND OCC. CLASSIFICATION	B (BUSINESS)
APPLICABLE CODES	BUILDING CODE: 2018 INTERNATIONAL BUILDING CODE MECHANICAL CODE: 2018 INTERNATIONAL MECHANICAL CODE PLUMBING CODE: 2018 INTERNATIONAL PLUMBING CODE FUEL GAS CODE: 2018 INTERNATIONAL FUEL GAS CODE ELECTRICAL CODE: 2017 NATIONAL ELECTRICAL CODE FIRE CODE: 2018 INTERNATIONAL FIRE CODE ENERGY CODE: 2018 INTERNATIONAL ENERGY CONSERVATION CODE

FIRE ALARM SYSTEM GENERAL NOTES

- PROVIDE FIRE ALARM SYSTEM TO ACCOMPLISH THE PARAMETERS BELOW.
- THE DRAWINGS INDICATE A PERFORMANCE SPECIFICATION FOR THE FIRE ALARM SYSTEM. CONTRACTOR IS RESPONSIBLE FOR DETAILED DESIGN AND PREPARATION OF SIGNED AND SEALED ENGINEERING DOCUMENTS FOR REVIEW/ APPROVAL FROM OWNERS INSURANCE CARRIER AND LOCAL AUTHORITY HAVING JURISDICTION. ALL MOBILES INTERFACING SIGNALS, SIGNAL LEVELS AND PROGRAMMING SHALL BE INCLUDED IN THE FIRE ALARM CONTRACTORS SCOPE OF WORK. SYSTEM SHALL BE IN COMPLIANCE WITH NFPA 72, IBC CODES, NATIONAL ELECTRICAL CODE, NFPA 101, 90A, ADA, AND THE AUTHORITY HAVING JURISDICTION (AHJ). REFER TO SPECIFICATIONS FOR ADDITIONAL INFORMATION.

MOUNTING HEIGHTS

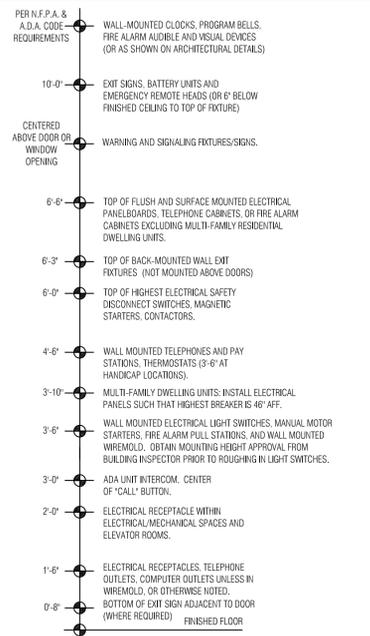

- NOTES:**
- MOUNTING HEIGHTS TO CENTER OF OUTLETS UNLESS OTHERWISE NOTED. IN MASONRY WALL CONSTRUCTION THE ABOVE MOUNTING HEIGHTS SHALL BE USED FOR REFERENCE TO NEAREST BLOCK OR BRICK COURSE.
 - THE ABOVE MOUNTING HEIGHTS SHALL BE ADHERED TO UNLESS SPECIFICALLY NOTED OR DETAILED OTHERWISE ON THE DRAWINGS OR SPECIFICATIONS.

ABBREVIATIONS

ABB.	DESCRIPTION	H.V.	HIGH VOLTAGE (PRIMARY)
A	AMPS	HW	HOT WATER HEATER
ABV.	ABOVE	IG	ISOLATED GROUND
A.F.F.	ABOVE FINISHED FLOOR	J.B.	JUNCTION BOX
A.F.G.	ABOVE FINISHED GRADE	KVA	KILOVOLT-AMPERE
A.H.U.	AIR HANDLER UNIT	KW	KILOWATT
C.B.	CIRCUIT BREAKER	LTG.	LIGHTING
C.H.	CABINET HEATER	L.V.	LOW VOLTAGE
CL.G.	CEILING	M.C.	MECHANICAL CONTRACTOR
CONC.	CONCRETE	MCB	MAIN CIRCUIT BREAKER
COND.	CONDENSER	MECH.	MECHANICAL
CONTR.	CONTRACTOR	MLO	MAIN LUGS ONLY
D.E.	DUAL ELEMENT (TIME DELAY)	MOD	MOTOR OPERATED DOOR
DNLT.	DOWNLIGHT	MT.	MOUNT
DWG.	DRAWING	MTD.	MOUNTED
E.B.H.	ELECTRIC BASEBOARD HEATER	N.L.	NIGHT LIGHTING
E.C.	ELECTRICAL CONTRACTOR	P.C.	PLUMBING CONTRACTOR
E.F.	EXHAUST FAN	PLG	PLUMBING
ELECT.	ELECTRIC	P.S.	PAY STATION
EM	INDICATES LIGHT FIXTURE OR DEVICE WIRED TO EMERGENCY CIRCUIT	R.T.U.	ROOF TOP UNIT
E.P.O.	EMERGENCY POWER-OFF PUSHBUTTON SWITCH	SLD	SINGLE LINE DIAGRAM
EUH	ELECTRIC UNIT HEATER	SP/ST	SINGLE POLE/SINGLE THROW
EW	ELECTRIC WATER COOLER	S/S	SAFETY SWITCH (DISCONNECT SWITCH)
EW	ELECTRIC WALL HEATER	EXST.	EXISTING
EXST.	EXISTING	SW	SWITCH
FACP	FIRE ALARM CONTROL PANEL	T/C	TIME CLOCK
FATB	FIRE ALARM TERMINAL BOX	UH	UNIT HEATER
FSD	FIRE SMOKE DAMPER	U.O.N.	UNLESS OTHERWISE NOTED
FU.	FUSE (OR FUSED)	V	VOLTS
G.C.	GENERAL CONTRACTOR	VAV	VARIABLE AIR VOLUME
GEN.	GENERAL	WP	WEATHERPROOF
G.F.I.	GROUND FAULT INTERRUPT	WR	WEATHERPROOF
GND.	GROUND	XMPR.	TRANSFORMER
HP	HORSE POWER	(E)	EXISTING TO REMAIN
HTR.	HEATER	(R)	REMOVE EXISTING
HVAC	HEATING, VENTILATING, & AIR CONDITIONING	(RL)	RELOCATED EXISTING

BRANCH & FEEDER CIRCUIT SCHEDULE

COPPER (CU)						ALUMINUM (AL)						REMARKS	
WIRE ID	# OF WIRES	GROUND	CONDUIT	# OF WIRES	GROUND	CONDUIT	WIRE ID	# OF WIRES	GROUND	CONDUIT	# OF WIRES		GROUND
20W2	2# 12	1# 12 G.	3/4"	2# 10	1# 12 G.	3/4"	225W4	4# 4/0	1# 4 G.	2"	4-300 KCML	1# 2 G.	2 1/2"
30W2	2# 10	1# 10 G.	3/4"	2# 8	1# 8 G.	3/4"	30W4	4-250 KCML	1# 4 G.	2 1/2"	4-350 KCML	1# 2 G.	2 1/2"
35W2	2# 10	1# 10 G.	3/4"	2# 8	1# 8 G.	3/4"	300W4	4-350 KCML	1# 4 G.	2 1/2"	4-500 KCML	1# 2 G.	3"
40W2	2# 8	1# 10 G.	3/4"	2# 8	1# 8 G.	3/4"	350W4	4-500 KCML	1# 3 G.	3"	(2) 4# 4/0	(2) 1# 1 G.	(2) 2"
45W2	2# 8	1# 10 G.	3/4"	2# 6	1# 8 G.	3/4"	400W4	4-600 KCML	1# 3 G.	3 1/2"	(2) 4-250 KCML	(2) 1# 1 G.	(2) 2 1/2"
50W2	2# 8	1# 10 G.	3/4"	2# 6	1# 8 G.	3/4"	450W4	(2) 4# 4/0	(2) 1# 2 G.	(2) 3"	(2) 4-300 KCML	(2) 1# 1/0 G.	(2) 2 1/2"
60W2	2# 6	1# 10 G.	3/4"	2# 4	1# 8 G.	3/4"	500W4	(2) 4-250 KCML	(2) 1# 2 G.	(2) 2 1/2"	(2) 4-350 KCML	(2) 1# 1/0 G.	(2) 2 1/2"
70W2	2# 4	1# 8 G.	1"	2# 2	1# 6 G.	1"	600W4	(2) 4-350 KCML	(2) 1# 1 G.	(2) 3"	(2) 4-500 KCML	(2) 1# 2/0 G.	(2) 3"
80W2	2# 4	1# 8 G.	1"	2# 2	1# 6 G.	1"	800W4	(2) 4-600 KCML	(2) 1# 1/0 G.	(2) 4"	(3) 4-400 KCML	(3) 1# 3/0 G.	(3) 3 1/2"
90W2	2# 2	1# 8 G.	1 1/4"	2# 2	1# 6 G.	1 1/4"	1000W4	(3) 4-400 KCML	(3) 1# 2/0 G.	(3) 3"	(3) 4-600 KCML	(3) 1# 4/0 G.	(3) 3 1/2"
100W2	2# 2	1# 8 G.	1 1/4"	2# 1	1# 6 G.	1 1/4"	1200W4	(3) 4-600 KCML	(3) 1# 3/0 G.	(3) 3 1/2"	(4) 4-500 KCML	(4) 250 KCML	(4) 3"
20W3	3# 12	1# 12 G.	3/4"	3# 10	1# 10 G.	3/4"	100N4	5# 1/0 (2@N)	1# 6 G.	1 1/4"	5# 2/0 (2@N)	1# 4 G.	2"
25W3	3# 12	1# 10 G.	3/4"	3# 10	1# 8 G.	3/4"	125N4	5# 1/0 (2@N)	1# 6 G.	1 1/4"	5# 3/0 (2@N)	1# 4 G.	2"
30W3	3# 10	1# 10 G.	3/4"	3# 8	1# 8 G.	3/4"	150N4	5# 3/0 (2@N)	1# 6 G.	1 1/2"	5# 4/0 (2@N)	1# 4 G.	2 1/2"
40W3	3# 8	1# 10 G.	3/4"	3# 8	1# 8 G.	3/4"	200N4	5-250KCML (2@N)	1# 6 G.	2"	5-350KCML (2@N)	1# 2 G.	3"
50W3	3# 8	1# 10 G.	3/4"	3# 6	1# 8 G.	3/4"	225N4	5-300KCML (2@N)	1# 4 G.	2"	5-400KCML (2@N)	1# 2 G.	3"
60W3	3# 6	1# 10 G.	3/4"	3# 4	1# 8 G.	3/4"	250N4	5-350KCML (2@N)	1# 4 G.	2 1/2"	5-500KCML (2@N)	1# 2 G.	2 1/2"
70W3	3# 4	1# 8 G.	1"	3# 2	1# 6 G.	1"	250W4	4-250 KCML	1# 2 G.	2 1/2"	4-350 KCML	1# 1/0 G.	3"
80W3	3# 4	1# 8 G.	1"	3# 2	1# 6 G.	1"	300W4	4-350 KCML	1# 2 G.	3 1/2"	4-500 KCML	1# 1/0 G.	3"
90W3	3# 2	1# 8 G.	1"	3# 2	1# 6 G.	1"	350W4	4-500 KCML	1# 1/0 G.	3"	(2) 4# 4/0	(2) 1# 3/0 G.	(2) 2"
100W3	3# 2	1# 8 G.	1"	3# 1	1# 6 G.	1 1/4"	400W4	4-600 KCML	1# 1/0 G.	3 1/2"	(2) 4-250 KCML	(2) 1# 3/0 G.	(2) 3"
110W3	3# 2	1# 8 G.	1"	3# 1/0	1# 6 G.	1 1/4"	450W4	(2) 4# 4/0	(2) 1# 2/0 G.	(2) 2"	(2) 4-300 KCML	(2) 1# 3/0 G.	(2) 2 1/2"
125W3	3# 1	1# 6 G.	1 1/4"	3# 2/0	1# 6 G.	1 1/2"	600W4	(2) 4-350 KCML	(2) 1# 2/0 G.	(2) 3"	(2) 4-500 KCML	(2) 1# 4/0 G.	(3) 3 1/2"
150W3	3# 1/0	1# 6 G.	1 1/4"	3# 3/0	1# 6 G.	1 1/2"	750W4	(2) 4-500 KCML	(2) 1# 3/0 G.	(2) 3 1/2"	(3) 4-400 KCML	(3) 250 KCML	(3) 3"
175W3	3# 2/0	1# 6 G.	1 1/2"	3# 4/0	1# 4 G.	2"	800W4	(2) 4-600 KCML	(2) 1# 3/0 G.	(2) 3 1/2"	(3) 4-400 KCML	(3) 250 KCML	(3) 3"
200W3	3# 3/0	1# 6 G.	1 1/2"	3-250KCML	1# 4 G.	2"	1000W4	(3) 4-400 KCML	(3) 1# 3/0 G.	(3) 3"	(3) 4-600 KCML	(3) 250 KCML	(3) 3 1/2"
225W3	3# 4/0	1# 4 G.	2"	3-300 KCML	1# 4 G.	2"	1200W4	(3) 4-600 KCML	(3) 1# 3/0 G.	(3) 3 1/2"	(4) 4-500 KCML	(4) 250 KCML	(4) 3 1/2"
250W3	3-250 KCML	1# 4 G.	2"	3-350 KCML	1# 4 G.	2 1/2"	1600W4	(4) 4-600 KCML	(4) 1# 3/0 G.	(4) 3 1/2"	(5) 4-600 KCML	(5) 250 KCML	(5) 3 1/2"
300W3	3-350 KCML	1# 4 G.	2 1/2"	3-500 KCML	1# 2 G.	2 1/2"	2000W4	(5) 4-600 KCML	(5) 1# 3/0 G.	(5) 3 1/2"	(6) 4-600 KCML	(6) 250 KCML	(6) 3 1/2"
350W3	3-500 KCML	1# 2 G.	2 1/2"	(2) 3# 4/0	(2) 1# 2 G.	(2) 2"							
400W3	3-600 KCML	1# 3 G.	3"	(2) 3-250 KCML	(2) 1# 1 G.	2"							
60W4	4# 4	1# 10 G.	3/4"	4# 4	1# 8 G.	1"							
75W4	4# 4	1# 8 G.	1"	4# 2	1# 6 G.	1 1/4"							
100W4	4# 2	1# 8 G.	1 1/4"	4# 1	1# 6 G.	1 1/4"							
125W4	4# 1	1# 6 G.	1 1/4"	4# 2/0	1# 4 G.	2"							
150W4	4# 1/0	1# 6 G.	1 1/2"	4# 3/0	1# 4 G.	2"							
175W4	4# 2/0	1# 6 G.	2"	4# 4/0	1# 4 G.	2"							
200W4	4# 3/0	1# 6 G.	2"	4-250KCML	1# 4 G.	2 1/2"							

NOTE: (#) DENOTES NUMBER OF SETS OF WIRES & CONDUITS

DENOTES NUMBER OF PHASE/LINE & NEUTRAL CONDUCTORS WIRE. X DENOTES SEPARATELY DERIVED SYSTEMS, SERVICES AND TRANSFORMER SECONDARIES. # DENOTES AMPERE VALUE

THIS CHART IS BASED UPON INSULATED WIRE IN CONDUIT - NEC TABLE 310.15(B)(16), 60 DEG COLUMN #1 AND LESS 75 DEG COLUMN #1/0 AND GREATER

① ROMEX IS ACCEPTABLE FOR APARTMENT UNIT BRANCH CIRCUIT WIRING.

② DISTRIBUTION FOR HIGH HARMONIC CONTENT SERVICE, DE-RATED FEEDERS WITH OVERSIZED NEUTRALS

ELECTRICAL SYMBOLS

2'X4 RECESSED LED FIXTURE: "A" INDICATES TYPE, "2" INDICATES CIRCUIT BREAKER POSITION, "3" INDICATES SWITCHING

2'X4 RECESSED LED FIXTURE CONNECTED TO EMERGENCY (EM) AND/OR NIGHT LIGHT (NL) CIRCUIT: "A" INDICATES TYPE, "2" INDICATES CIRCUIT BREAKER POSITION, "3" INDICATES SWITCHING

2'X2 RECESSED LED FIXTURE: "A" INDICATES TYPE, "2" INDICATES CIRCUIT BREAKER POSITION, "3" INDICATES SWITCHING

2'X2 RECESSED LED FIXTURE CONNECTED TO EMERGENCY (EM) AND/OR NIGHT LIGHT (NL) CIRCUIT: "A" INDICATES TYPE, "2" INDICATES CIRCUIT BREAKER POSITION, "3" INDICATES SWITCHING

PENDANT MOUNTED LIGHT FIXTURE: "A" INDICATES TYPE, "2" INDICATES CIRCUIT BREAKER POSITION, "3" INDICATES SWITCHING

RECESSED DOWNLIGHT: "A" INDICATES TYPE, "2" INDICATES CIRCUIT BREAKER POSITION, "3" INDICATES SWITCHING

RECESSED WALLWASHER DOWNLIGHT: "A" INDICATES TYPE, "2" INDICATES CIRCUIT BREAKER POSITION, "3" INDICATES SWITCHING

WALL MOUNTED LIGHT FIXTURE: "A" INDICATES TYPE, "2" INDICATES CIRCUIT BREAKER POSITION, "3" INDICATES SWITCH CONTROL

CEILING OR WALL MOUNTED EXIT SIGN WITH INTEGRAL EMERGENCY LIGHT HEADS: "A" INDICATES TYPE, "2" INDICATES CIRCUIT BREAKER POSITION, "3" INDICATES SWITCHING UNLESS OTHERWISE NOTED

WALL OR CEILING MOUNTED EMERGENCY BATTERY PACK WITH (2) LIGHT HEADS: "EM" INDICATES TYPE, CONNECT TO LOCAL LIGHTING BRANCH CIRCUIT AHEAD OF ALL SWITCHING UNLESS OTHERWISE NOTED

WALL OR CEILING MOUNTED SINGLE HEAD OR TWIN REMOTE EMERGENCY LIGHT: "EM" INDICATES TYPE, "WP" INDICATES WEATHERPROOF

CEILING MOUNTED PADDLE FAN: "A" INDICATES TYPE, "2" INDICATES CIRCUIT BREAKER POSITION

FIRE ALARM SMOKE DETECTOR

FIRE ALARM DUCT SMOKE DETECTOR

FIRE ALARM HEAT DETECTOR

FIRE ALARM ADDRESSABLE MODULE

CEILING MOUNTED 125V, COMBINATION SMOKE DETECTOR/HORN-STROBE

CEILING MOUNTED 125V, CARBON MONOXIDE DETECTOR

FIRE ALARM PULL STATION

FIRE ALARM STROBE

FIRE ALARM HORNS-STROBE

SECURITY CAMERA

125V, 20A TOGGLE SWITCH MOUNTED AT 42" AFF UNLESS OTHERWISE NOTED.

125V, 20A DIMMER SWITCH MOUNTED AT 42" AFF UNLESS OTHERWISE NOTED.

125V, 20A DOOR JAMB SWITCH MOUNTED AT 42" AFF UNLESS OTHERWISE NOTED.

125V, 20A CEILING FAN SPEED SWITCH MOUNTED AT 42" AFF UNLESS OTHERWISE NOTED.

125V, 20A 3-WAY TOGGLE SWITCH MOUNTED AT 42" AFF UNLESS OTHERWISE NOTED.

125V, 20A BATHROOM EXHAUST FAN TIMER SWITCH MOUNTED AT 42" AFF UNLESS OTHERWISE NOTED.

WALL MOUNTED DUAL TECHNOLOGY OCCUPANCY SENSOR


CEILING MOUNTED DUAL TECHNOLOGY OCCUPANCY SENSOR

125V, 20A SIMPLEX RECEPTACLE MOUNTED AT 18" AFF UNLESS OTHERWISE NOTED.


125V, 20A DUPLEX RECEPTACLE MOUNTED AT 18" AFF UNLESS OTHERWISE NOTED. 1-1 INDICATES MOUNTED AT 42" AFF OR 6" ABOVE COUNTER OR BACKSPLASH.

125V, 20A DUPLEX GFCI RECEPTACLE MOUNTED AT 18" AFF UNLESS OTHERWISE NOTED. 1-1 INDICATES MOUNTED AT 42" AFF OR 6" ABOVE COUNTER OR BACKSPLASH. "WP" INDICATES WEATHERPROOF ENCLOSURE.


CEILING MOUNTED 125V,

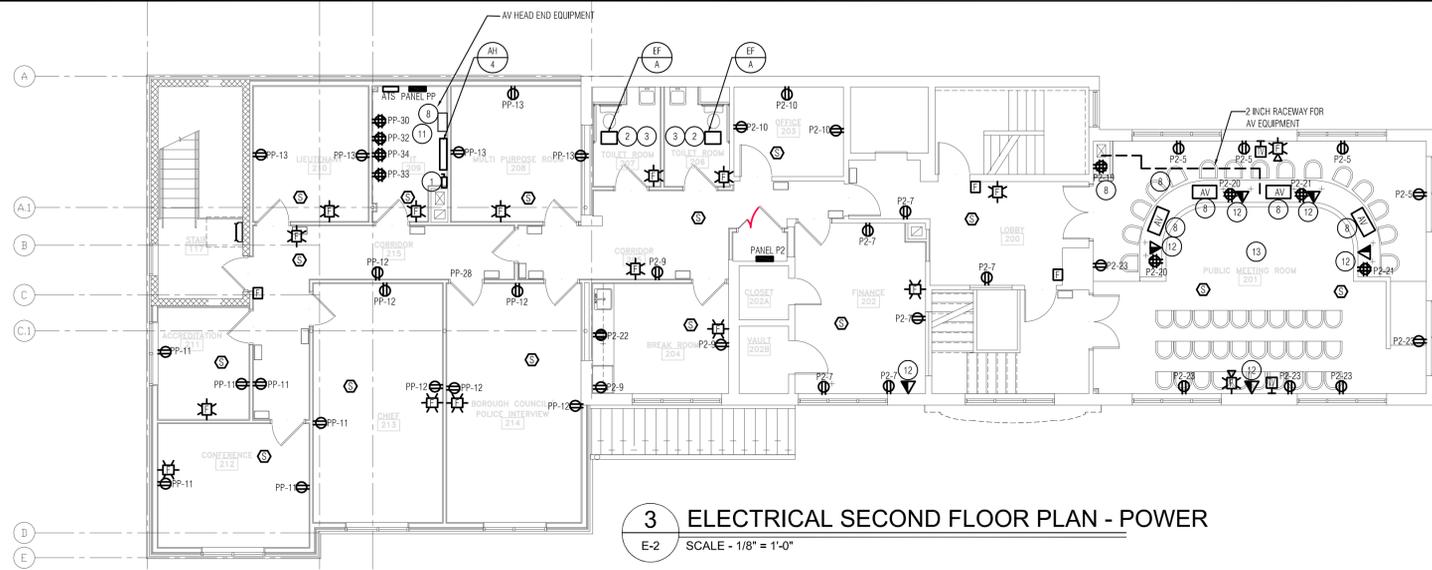

3 ELECTRICAL SECOND FLOOR PLAN - POWER
E-2 SCALE - 1/8" = 1'-0"

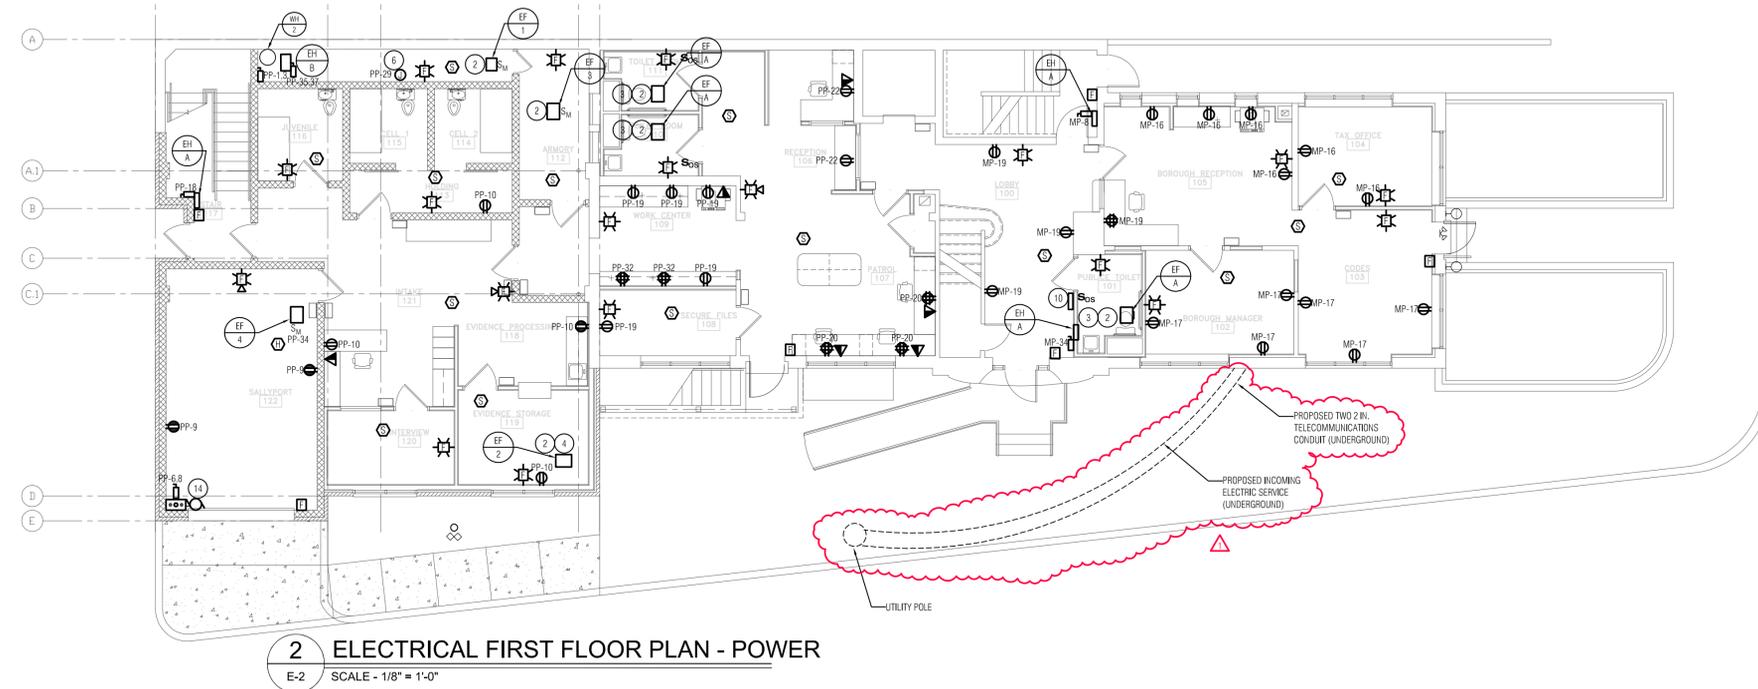

2 ELECTRICAL FIRST FLOOR PLAN - POWER
E-2 SCALE - 1/8" = 1'-0"

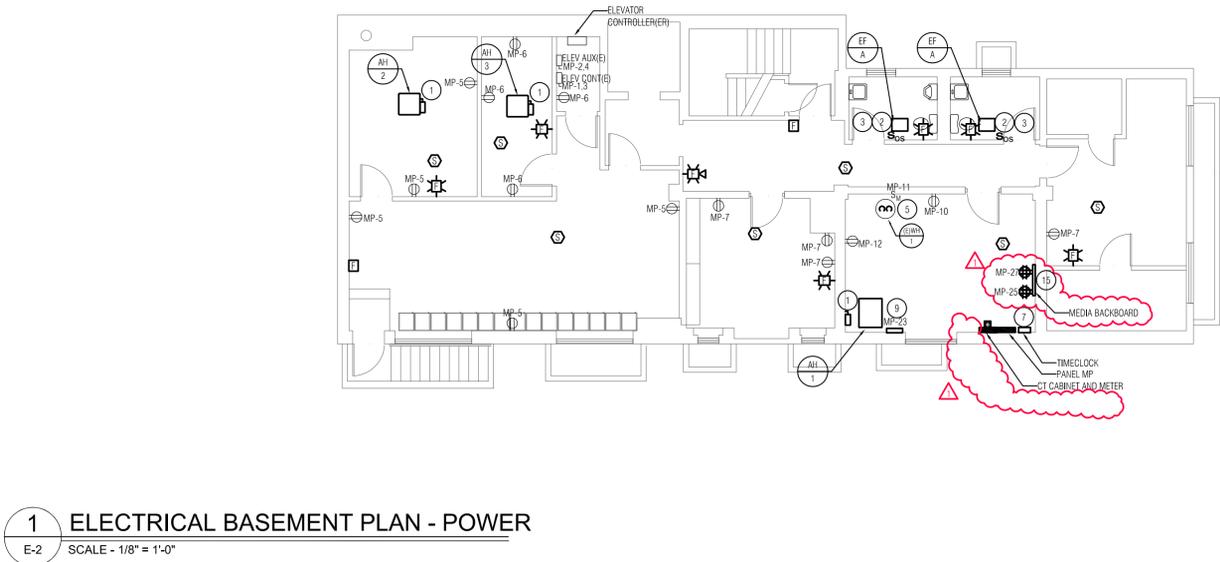

1 ELECTRICAL BASEMENT PLAN - POWER
E-2 SCALE - 1/8" = 1'-0"

ELECTRICAL SHEET NOTES:

- ALL SINGLE PHASE BRANCH CIRCUITING SHALL BE 2#12 & 1#12GND - 3/4" UN. ALL THREE PHASE BRANCH CIRCUITING SHALL BE 3#12 & 1#12GND 3/4" UN. ROUTE ALL BRANCH CIRCUITS TO PANEL INDICATED IN ROOM UN. REFER TO SINGLE LINE DIAGRAM FOR ADDITIONAL WIRE SIZES. REFER TO APPROPRIATE TRADE DRAWINGS FOR EXACT LOCATION OF HVAC, PLUMBING, AND ARCHITECTURAL EQUIPMENT.
- COORDINATE EXACT LOCATION OF RECEPTACLES AND TELECOMMUNICATION DEVICES WITH FURNITURE MILLWORK, AND EQUIPMENT SECURITY SYSTEMS TO BE DETERMINED BY AND CAMERAS). COORDINATE POWER REQUIREMENTS WITH SECURITY CONTRACTORS.
- TELEDATA OUTLETS HOMERUN TO IT ROOM.

ELECTRICAL NEW WORK KEY NOTES

- INDOOR AIR HANDLER POWERED BY OUTDOOR CONDENSING UNIT.
- CIRCUIT EXHAUST FANS TO NEAREST LIGHTING CIRCUIT. SEE E-4 FOR LIGHTING CIRCUITING.
- INTERCONNECT EXHAUST FAN WITH BATHROOM OCCUPANCY SENSOR SWITCH. SEE E-4 FOR OCCUPANCY SENSOR LOCATIONS.
- INTERCONNECT EXHAUST FAN WITH EVIDENCE ROOM OCCUPANCY SENSOR SWITCH. SEE E-4 FOR OCCUPANCY SENSOR LOCATIONS.
- HOT WATER RECHRG PUMP. COORDINATE POWER REQUIREMENTS AND FINAL LOCATION WITH PLUMBING CONTRACTOR.
- JUNCTION BOX FOR SOLENOID VALVE CONTROLLER. COORDINATE POWER REQUIREMENTS AND FINAL LOCATION WITH PLUMBING CONTRACTOR PRIOR TO ROUGH-IN.
- TIMECLOCK FOR SITE LIGHTING CIRCUITS. TIME CLOCK SHALL BE 365 DAY PROGRAMMABLE ASTRONOMIC TYPE WITH PHOTOCCELL OVERRIDE. TIME CLOCK SHALL BE INTERMATIC TYPE ET9015OR OR APPROVED EQUAL.
- AV EQUIPMENT, AV OUTLETS, RACEWAY, AND QUAD RECEPTACLE AND HEAD END EQUIPMENT ARE DIAGRAMMATIC ONLY. COORDINATE LOCATION, ROUTING, INSTALLATION, AND POWER REQUIREMENTS WITH AV CONTRACTOR IN FIELD PRIOR TO ROUGH-IN.
- FIRE ALARM CONTROL PANEL. COORDINATE LOCATION WITH FIRE MARSHALL PRIOR TO ROUGH-IN.
- FIRE ALARM ANNUNCIATOR PANEL. COORDINATE LOCATION WITH FIRE MARSHALL.
- IT ROOM RECEPTACLES. COORDINATE FINAL LOCATIONS WITH BOROUGH STAFF PRIOR TO ROUGH-IN.
- MOUNT TELE/DATA OUTLETS, QUAD RECEPTACLES, AND AV OUTLETS IN FURNITURE. COORDINATE MOUNTING AND FINAL LOCATION WITH GENERAL CONTRACTOR.
- FLOORBOX POWER RACEWAY. ROUTING/FINAL LOCATION OF RACEWAY TO BE DETERMINED IN-FIELD PRIOR TO ROUGH-IN.
- GARAGE DOOR OPENER CONTROLS. COORDINATE FINAL LOCATION AND ELECTRICAL CHARACTERISTICS WITH APPROVED SUBMITTAL PRIOR TO ROUGH-IN.
- 4X8 FIRE RESISTANT PLYWOOD BACKBOARD TO TELECOM/CABLE SERVICE EQUIPMENT.

LINN ARCHITECTS
ARCHITECTURE
ENGINEERING
SITE PLANNING
INTERIOR DESIGN

140 N. PROVIDENCE ROAD
MEDIA, PENNSYLVANIA 19063
TEL: 610-566-7044
FAX: 610-566-3258

ADVANCED ENGINEERING INC.
ARCHITECTURE
ENGINEERING
INTERIOR DESIGN

5001 Pennell Road, Media, PA 19063
Project No. 22065

ELECTRICAL FLOOR POWER PLAN - NEW WORK
RENOVATIONS TO MUNICIPAL BUILDING
BOROUGH OF EDDYSTONE
1300 E. 12TH ST.
EDDYSTONE, PA 19022

DATE	REVISIONS	DESCRIPTION	DATE
2/22/23	NO. 1	Issued for Bid	1/31/23
	NO. 2	Addendum 3	2/22/23

SCALE: AS NOTED
DRAWN BY: AH
CHECKED BY: DWF
PROJ. NO.: 22065

SHEET NO. **E-2** OF SHEET

Main Panel(MP)

LOCATION: BASEMENT MECHANICAL ROOM
MOUNTING: SURFACE

VOLTAGE: 120/240 V, 1φ, 3 W
MAIN: 400 A MCB
NEUTRAL: 100%
AIC RATING

CKT NO.	WIRE ID	CB AMP/POLE	DESCRIPTION	LOAD (KW)				DESCRIPTION	CB AMP/POLE	WIRE ID	CKT NO.
				A	B	A	B				
1	60W3	60A/2P	Elevator Controller	2520		2500		Elevator Auxiliary	30A/2P	30W3	2
3					2520		2500				4
5	20W2	20A/1P	Receptacles-Basement Storage	900		540		Receptacles-Fire Marshall	20A/1P	20W2	6
7	20W2	20A/1P	Receptacles-Mechanical Room		900		1800	EH-A(Stairwell)	20A/1P	20W2	8
9	20W2	20A/1P	Existing Sump Pump**	500		360		Receptacles-Mechanical Room*	20A/1P	20W2	10
11	20W2	20A/1P	Hot Water Recirc Pump		500		540	Receptacles-Mechanical Room*	20A/1P	20W2	12
13	20W2	20A/1P	Existing Lighting	1000		200		Exterior Lighting***	20A/1P	20W2	14
15	20W2	20A/1P	Existing Lighting		1000		900	Receptacles-Rms 104&105	20A/1P	20W2	16
17	20W2	20A/1P	Receptacles-Rms 102&103	1080		400		Borough Reception Fobs	20A/1P	20W2	18
19	20W2	20A/1P	Receptacles-Lobby Receptacles		900			Parking Lot Lighting(Future)			20
21	20W2	20A/1P	First Floor Lighting	800							22
23	20W2	20A/1P	FACP		500						24
25	20W2	20A/1P	Tele/Data Receptacles	360				Parking Lot Lighting(Future)			26
27	20W2	20A/1P	Tele/Data Receptacles		360			SPARE	20A/1P		28
29	20W2	225A/2P	Panel PP	16500		11500		Panel P2	100A/2P		30
31					16500		11500				32
33		20A/1P	SPARE			1800		EH-A(Stairwell 117)	20A/1P	20W2	34
35		20A/1P	SPARE					SPARE	20A/1P		36
37		20A/1P	SPARE					SPARE	20A/1P		38
39			SPACE					SPACE			40
41			SPACE					SPACE			42
SUB-TOTAL KW				23.7	23.2	17.3	17.2	SUB-TOTAL KW			
TOTAL CONNECTED KVA LOAD				81.4 KVA				NOTES: *USE GFCI BREAKER			
TOTAL CONNECTED AMP LOAD				339.1 A				** CONFIRM POWER REQUIREMENTS IN FIELD			
								***CIRCUIT THROUGH TIMECLOCK			

Second Floor Panel(P2)

LOCATION: CORRIDOR 205 CLOSET
MOUNTING: SURFACE

VOLTAGE: 120/240 V, 1φ, 3 W
MAIN: 100 A MCB
NEUTRAL: 100%

CKT NO.	WIRE ID	CB AMP/POLE	DESCRIPTION	LOAD (KW)				DESCRIPTION	CB AMP/POLE	WIRE ID	CKT NO.
				A	B	A	B				
1	30W3	30A/2P	CU-1	900		1940		RTU-2	30A/2P	40W3	2
3					900		1940				4
5	20W2	20A/1P	Receptacles-Public Meeting Room	720		2500		RTU-3	40A/2P	40W3	6
7	20W2	20A/1P	Receptacles-Finance Office		1080		2500				8
9	20W2	20A/1P	Receptacles-2nd Floor Break Room	720		540		Receptacles-Office Rm 203	20A/1P		10
11	30W3	30A/2P	CU-2	900		1940		RTU-4	30A/2P	40W3	12
13					900		1940				14
15	20W2	20A/1P	Rms 202/203/204 Fobs		400		800	2nd Floor Lighting	20A/1P	20W2	16
17	20W2	20A/1P	2nd Floor Lobby Fobs	400		240		Stairwell Lighting	20A/1P	20W2	18
19	20W2	20A/1P	AV Closet Receptacle		360		720	Floorbox Receptacles-Pub Meeting	20A/1P	20W2	20
21	20W2	20A/1P	Floorbox Receptacles-Pub Meeting	720				Receptacles-2nd Floor Break Room	20A/1P	20W2	22
23	20W2	20A/1P	Receptacles-Public Meeting Room		720			SPARE	20A/1P		24
25	20W2	20A/1P	Roofbox Receptacles	360				SPARE	20A/1P		26
27		20A/1P	SPARE					SPARE	20A/1P		28
29		20A/1P	SPARE					SPARE	20A/1P		30
31		20A/1P	SPARE					SPARE	20A/1P		32
33		20A/1P	SPARE					SPARE	20A/1P		34
35			SPACE					SPACE			36
37			SPACE					SPACE			38
39			SPACE					SPACE			40
41			SPACE					SPACE			42
SUB-TOTAL KW				4.7	4.4	7.2	7.9	SUB-TOTAL KW			
TOTAL CONNECTED KVA LOAD				24.1 KVA				NOTES:			
TOTAL CONNECTED AMP LOAD				100.6 A							

Police Panel(PP)

LOCATION: IT ROOM
MOUNTING: SURFACE

VOLTAGE: 120/240 V, 1φ, 3 W
MAIN: 225 A MCB
NEUTRAL: 100%

CKT NO.	WIRE ID	CB AMP/POLE	DESCRIPTION	LOAD (KW)				DESCRIPTION	CB AMP/POLE	WIRE ID	CKT NO.
				A	B	A	B				
1	30W2	30A/2P	Electric Water Heater Holding Cell Area	2250		900		CU-3	30A/2P	30W3	2
3					2250		900				4
5	30W3	30A/2P	RTU-5	1940		1500		Overhead Door-Salleyport	20A/2P	20W3	6
7					1940		1500				8
9	20W2	20A/1P	Salleyport Receptacles	360		540		Receptacles-Rms 119,121,113	20A/1P	20W2	10
11	20W2	20A/1P	Receptacles-Rms 211,212		1080		1080	Receptacles-Rms 213, 214	20A/1P	20W2	12
13	20W2	20A/1P	Receptacles-Rms 208,209,210	1080		2500		RTU-1	40A/2P	40W3	14
15	20W2	20A/1P	First Floor Lighting		1575		2500				16
17	20W2	20A/1P	Second Floor Lighting	1350		1800		EH-A(Stairwell 117)	20A/1P	20W2	18
19	20W2	20A/1P	Receptacles-Work Center(Rm. 109)		1080		1080	Receptacles-Patrol Room 107	20A/1P	20W2	20
21	20W2	20A/1P	Patrol Fobs	400		360		Receptacles-Reception 106	20A/1P	20W2	22
23	20W2	20A/1P	Intake Fobs		400		400	Intake Fobs	20A/1P	20W2	24
25	20W2	20A/1P	Rms 119/120 Fobs	400		400		Rms 211/212/213 Fobs	20A/1P	20W2	26
27	20W2	20A/1P	Rms 208/214 Fobs		400		400	Rms 209/210/214 Fobs	20A/1P	20W2	28
29	20W2	20A/1P	Solenoid Valve Controller*	400		500		Receptacles-IT Room	20A/1P	20W2	30
31	20W2	20A/1P	Stairwell Lighting		105		500	Receptacles-IT Room	20A/1P	20W2	32
33	20W2	20A/1P	Receptacles-IT Room	500		500		Quad Receptacles - Work Center	20A/1P	20W2	34
35		20A/2P	EH-B		1500		720	EF-4	20A/1P	20W2	36
37								SPACE			38
39			SPACE					SPACE			40
41			SPACE					SPACE			42
SUB-TOTAL KW				10.2	10.3	9.0	9.1	SUB-TOTAL KW			
TOTAL CONNECTED KVA LOAD				38.6 KVA				NOTES: *USE GFCI BREAKER			
TOTAL CONNECTED AMP LOAD				160.8 A							

EDDYSTONE LIGHTING FIXTURE SCHEDULE

TYPE	DESCRIPTION	MANUFACTURER & MODEL NUMBER	SPECIFIED BY	VOLTAGE	LAMP				MOUNTING	CLG TYPE (GY/ACT)	REMARKS
					QUANTITY	WATTAGE	DIMMABLE	COLOR TEMP			
A1	2'X4 RECESSED TROFFER WITH PRISMATIC LENS	LITHONIA 2TL4-40L-RW-A19-EZ1-LP835	AEI	120	1	LED 32	Yes	3500K	4000	Recessed	GY/ACT
B1	2'X2 RECESSED TROFFER WITH PRISMATIC LENS	LITHONIA 2TL2-40L-RW-A19-EZ1-LP835	AEI	120	1	LED 35	Yes	3500K	4000	Recessed	GY/ACT
C	4' LED STRIP LIGHT	LITHONIA CLX-L48-5000LM-SEF-FDL-1M/VOLT-GZ10-35K-80CRI	AEI	MVOLT	1	LED 35	Yes	3500K	5000	Pendant/Surface	-
D	8" OPEN LED NON-IC DOWNLIGHT	LITHONIA RV8-30-20-R08-WR-120	AEI	120	1	LED 26	Yes	3000K	2000	Pendant/Surface	-
E	EXTERIOR - UP/DOWN OUTDOOR LED WALL CYLINDER LIGHTING FIXTURE	LITHONIA OLLWJ-LED-P1-40K-120-DARK BRONZE	AEI	120	1	LED 14	No	3500K	950	Surface	-
E2	PITCH SINGLE LIGHT 5" HIGH INTEGRATED LED OUTDOOR WALL SCONCE	TECH LIGHTING 700W-SPTS8-LED830	AEI	120	1	LED 26	No	3000K	823	Surface	-
E3	PREMIUM-DIE-CAST ARCHITECTURAL EMERGENCY LIGHT	LITHONIA LIGHTING AFF-OELR-DNAXD-WT	AEI	-	1	LED 8.5	No	-	-	Surface	-
G	6" OPEN LED DOWNLIGHT	LITHONIA LIGHTING LDN6-35-25-L06-WR-LSS-120	AEI	120	1	LED 35	YES	3500K	3130	Surface	GY/ACT
H	2'X2' HAZARDOUS LOCATION LED LUMINAIRE	KURTZON TLX12-R-2X2-2LED-R-840-LNW	AEI	MVOLT	1	LED 37	YES	4000K	4190	Recessed	-
ST	STAIRWELL FIXTURE	COLUMBIA ESL4-3SLW-FAW-EDU-ELL14-NXOS	AEI	120	1	LED 34.5	Yes	3500K	4000	Surface	-
SB	LANDSCAPE ACCENT UPLIGHT	HYDREL - ASPEN ASPEN A P1 80CRI 30K 120 25 WSL KM	AEI	120	1	LED 11	NO	3000K	600	Ground	-
X	EDGE-LIT LED EXIT SIGN	LITHONIA EDG-W-1-G-EL (SINGLE FACE) EDG-W-2-G-EL (DUAL FACE)	AEI	120	1	LED 3.8	NO	-	-	Surface	-
EM	LED EMERGENCY LIGHT	COMPASS CU2-SD	AEI	MVOLT	2	LED 1	NO	-	-	Surface	-

- LIGHTING FIXTURE SCHEDULE NOTES**
- REFER TO THE ARCHITECTURAL REFLECTED CEILING PLAN(S) FOR THE CEILING TYPE AND EXACT LOCATION OF ALL LIGHT FIXTURES.
 - PROVIDE PLASTER/DRUM CEILING FRAMING KITS WHERE APPLICABLE.
 - ALL LAMPS SHALL HAVE A COLOR RENDERING OF 90 DEGREES KELVIN, UNLESS OTHERWISE NOTED.
 - PROVIDE ALL ACCESSORIES NECESSARY FOR A COMPLETE AND OPERATIONAL SYSTEM.
 - ALL FIXTURES RECESSED WITHIN A FIRE RATED CEILING SHALL BE INSTALLED IN A FIRE RATED ENCLOSURE TO MAINTAIN THE CEILING FIRE RATING. THIS CAN BE DONE BY EITHER A FIRE RATED FIXTURE, A TENMAT ENCLOSURE, OR A
 - EC IS RESPONSIBLE FOR PROVIDING ALL POWER SUPPLIES, CONTROLS, HARDWARE, ETC. NEEDED FOR A COMPLETE INSTALLATION.

LINN ARCHITECTS

140 N. PROVIDENCE ROAD
MEDIA, PENNSYLVANIA 19063
TEL: 610-566-7044
FAX: 610-566-3258

ARCHITECTURE
ENGINEERING
SITE PLANNING
INTERIOR DESIGN




ELECTRICAL SCHEDULES

RENOVATIONS TO MUNICIPAL BUILDING
BOROUGH OF EDDYSTONE
1300 E. 12TH ST.
EDDYSTONE, PA 19022

NO.	DESCRIPTION	DATE
1	Issued for Bid	1/31/23
2	Addendum 3	2/22/23

DATE: 2/22/23
SCALE: AS NOTED
DRAWN BY: AH
CHECKED BY: DWF
PROJ. NO.: 22065

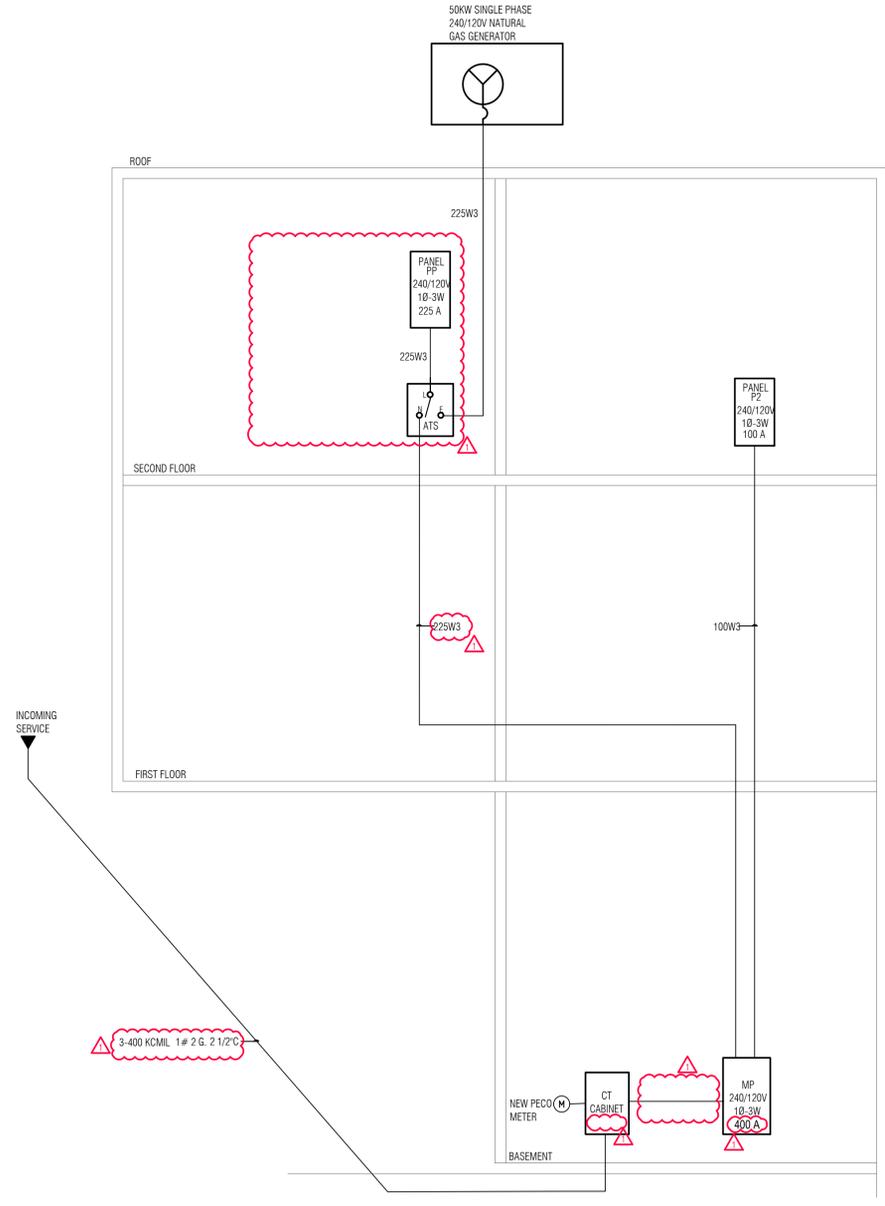

1 ELECTRICAL SINGLE LINE DIAGRAM
E-6 SCALE - NONE


DATE: 2/22/23
SHEET NO. **E-6**
SHEET OF

NO.	DESCRIPTION	DATE
1	Issued for Bid	1/31/23
3	Addendum	2/22/23


ELECTRICAL SINGLE LINE DIAGRAM
RENOVATIONS TO MUNICIPAL BUILDING
BOROUGH OF EDDYSTONE
1300 E. 12TH ST.
EDDYSTONE, PA 19022




LINN ARCHITECTS
ARCHITECTURE
ENGINEERING
SITE PLANNING
INTERIOR DESIGN
140 N. PROVIDENCE ROAD
MEDIA, PENNSYLVANIA 19063
TEL: 610-566-7044
FAX: 610-566-3258

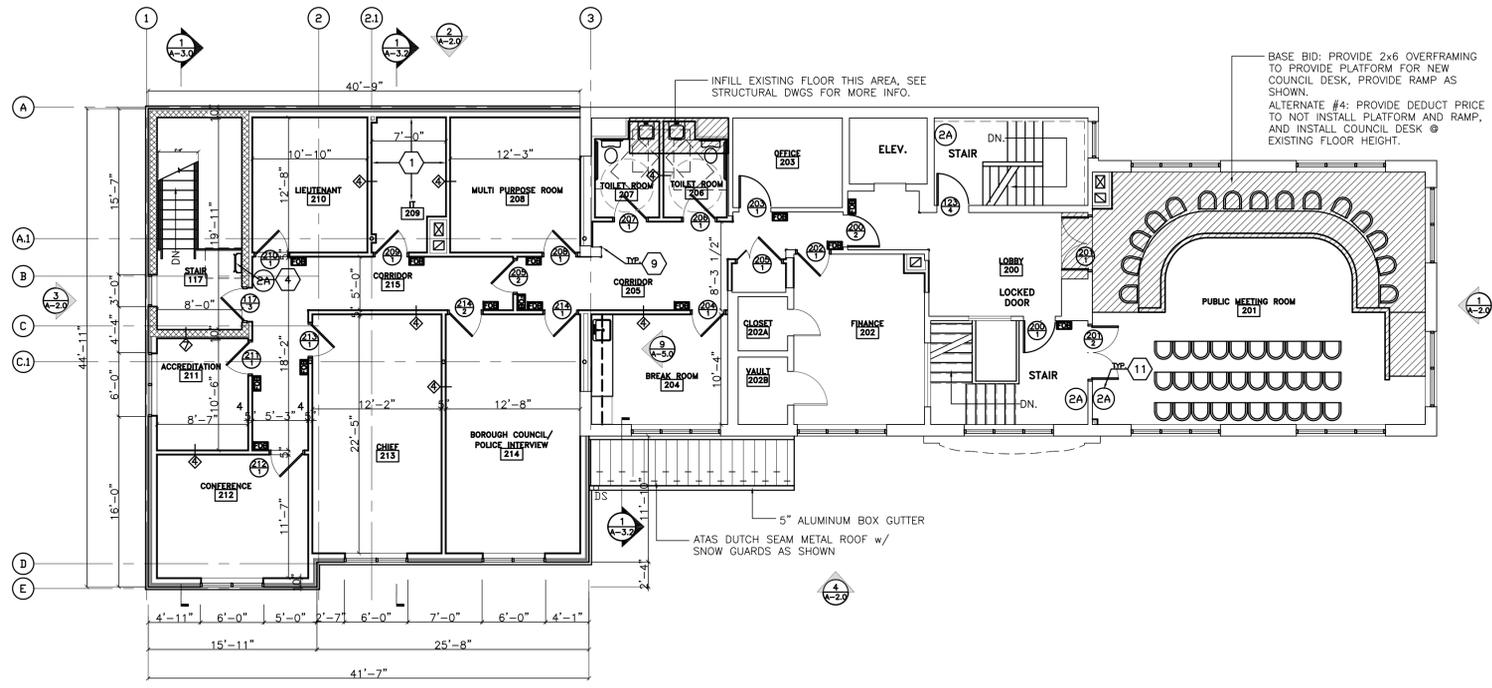

1 PROPOSED SECOND FLOOR PLAN
 SCALE: 1/8"=1'-0"

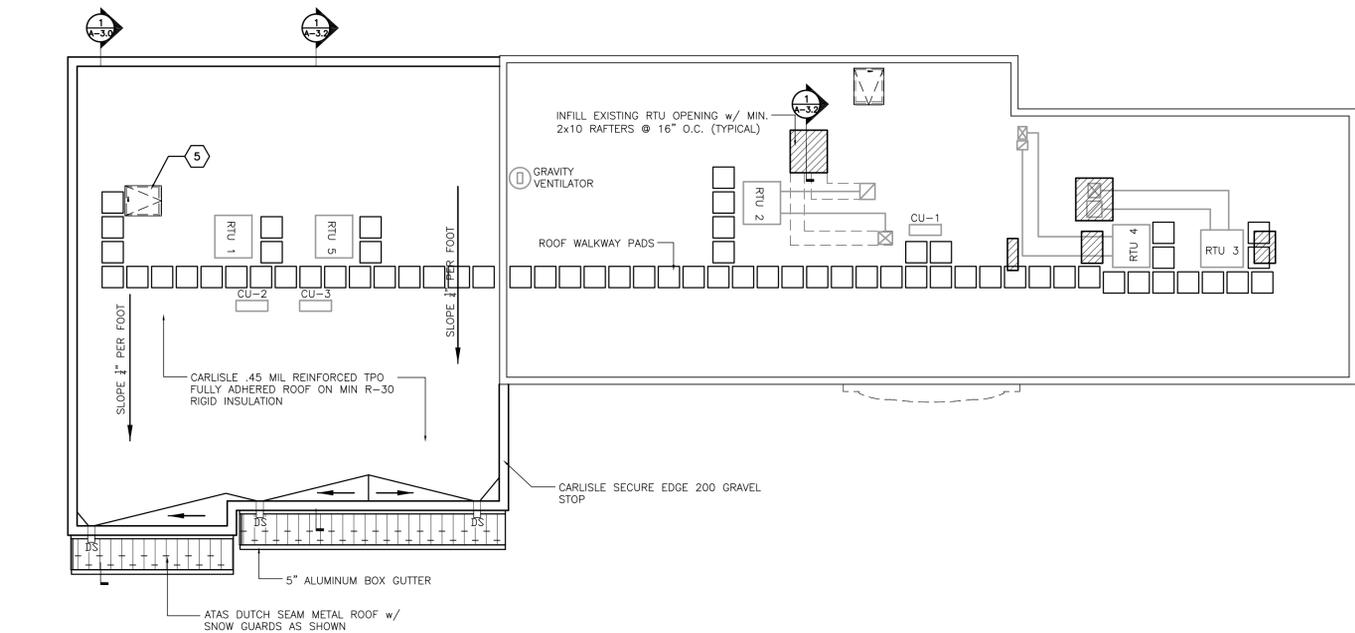

2 PROPOSED ROOF PLAN
 SCALE: 1/8"=1'-0"

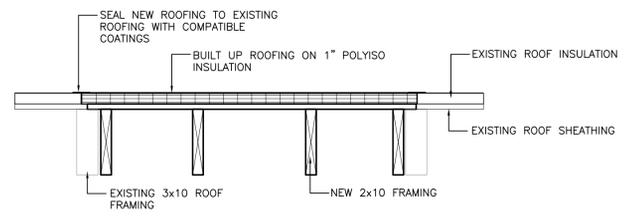

3 RTU ROOF INFILL
 SCALE: 1"=1'-0"

WALL TYPE LEGEND

- EXISTING WALL TO REMAIN FRAME OR MASONRY
- NEW EXTERIOR WALL - U935 1 HR - 8" CMU WALL w/ 1 1/2" RIGID INSULATION, CARLISLE CCW 705 AIR BARRIER, 1" AIR SPACE & 4" BRICK VENEER @ EXTERIOR, PTD. CMU @ INTERIOR
- NEW EXTERIOR WALL - 6" MTL. STUDS @ 16" O.C. w/ 5 1/2" KRAFT FACED BATT INSULATION, 1/2" DENS GLAS SHEATHING, CARLISLE CCW 705 AIR BARRIER, 2" AIR SPACE & 4" BRICK VENEER @ EXTERIOR, 5/8" GYP. BD. @ INTERIOR
- NEW (2) HOUR EXTERIOR WALL - 6" MTL. STUDS @ 16" O.C. w/ 5 1/2" FACED BATT INSULATION, 1/2" FIREGUARD DENS GLASS SHEATHING, CARLISLE CCW 705 AIR BARRIER, 1/2" METAL HAT CHANNEL @ 24" O.C. HORIZONTAL, 2" METL. SPAN CF42 INSULATED PANEL @ EXTERIOR, 5/8" FIRE CODE "X" GYP. BD. @ BOTH SIDES
- NEW INTERIOR WALL - 3 5/8" MTL. STUDS @ 16" O.C. w/ 3 1/2" UNFACED BATT INSULATION, & 5/8" GYP. BD. @ BOTH SIDES. RUN WALL TO 6" ABOVE SCHEDULED CEILING, RUN WALL FULL HEIGHT IF NO CEILING IS SCHEDULED PROVIDE DUROCK @ TILE LOCATIONS & MOISTURE RESISTANT DRYWALL IN TOILET ROOMS
- NEW INTERIOR WALL - 3 5/8" MTL. STUDS @ 16" O.C. w/ 3 1/2" UNFACED BATT INSULATION, 1/2" BULLET RESISTANT FIBERGLASS ARMOUR (LEVEL 3) & 5/8" ABUSE RESISTANT GYP. BD. @ BOTH SIDES. RUN WALL FULL HEIGHT, TIGHT TO BOTTOM OF DECK ABOVE
- NEW INTERIOR WALL - 8" CMU WALL PTD. BOTH SIDES
- NEW INTERIOR WALL - 8" CMU WALL PTD. 3 5/8" MTL. STUDS @ 16" O.C. w/ 3 1/2" UNFACED BATT INSULATION, & 5/8" DRYWALL.
- NEW INTERIOR WALL - 8" CMU WALL w/ 3" HAT CHANNEL @ 16" O.C. 5/8" GYP. BD. ON ONE FACE, PTD. CMU ON THE OPPOSITE FACE.

KEY NOTES:

- 1 PROVIDE 4x8x8" F.R.T. PLYWOOD, BEHIND GYPSUM BOARD FOR MOUNTING OF EQUIPMENT.
- 2 NEW PLASTIC LAMINATE CASEWORK WITH PLASTIC LAMINATE COUNTERTOPS
- 3 PRISONER LOCKERS - VANGUARD 3 TIER LOCKER 12X12 #6419R
- 4 ROOF HATCH AND ACCESS LADDER MODEL S20 AS MANUFACTURED BY BILCO - PROVIDE BLOCKING IN WALLS FOR LADDER ATTACHMENT
- 5 PATRIOT KNOCK DOWN DUTY LOCKERS #64KN242472 BY PENCO. COLOR TO BE SELECTED
- 6 PAINT EXISTING MASONRY.
- 7 OVERHEAD GARAGE DOOR MODEL THERMACORE MODEL # 596 DOOR SIZE 10'X9' AS MANUFACTURED BY OVERHEAD DOOR COMPANY OR APPROVED EQUAL. PROVIDE ALUM. SASH SECTION COLOR TO BE GRAY & RMX MEDIUM DUTY OPERATOR AND ALL ASSOCIATED HARDWARE FOR A COMPLETE INSTALLATION.
- 8 4" CONCRETE WALK ON 4" CRUSHED STONE W/ W1.4 X W1.4 6X6 WWF. PROVIDE CONTROL JOINTS @ 5'-0" O/C. & EXPANSION JOINT @ 20'-0" O.C.
- 9 NEW VINYL CORNER GUARDS- MODEL SOU AS MANUFACTURED BY JC- INDUSTRIES, 48" LENGTH WITH 2" WINGS
- 10 SECURITY WINDOW AS MANUFACTURED BY NORTH AMERICAN BULLETPROOF - PROVIDE LEVEL 3 SECURITY
- 11 2A FIRE EXTINGUISHER MTD. 48" TO TOP.
- 12 NEW FLAG POLES WITH LED LIGHTING, GC TO RUN CONDUIT AND CIRCUITING FOR NEW LIGHTING.

LINN ARCHITECTS
 ARCHITECTURE
 ENGINEERING
 SITE PLANNING
 INTERIOR DESIGN


140 N. PROVIDENCE ROAD
 MEDIA, PENNSYLVANIA 19063
 TEL: 610-566-7044
 FAX: 610-566-3258

PROPOSED FLOOR PLANS
 RENOVATIONS TO MUNICIPAL BUILDING
 BOROUGH OF EDDYSTONE
 1300 E. 12TH ST.
 EDDYSTONE, PA 19022


DATE	REVISIONS	DESCRIPTION	DATE
01.31.23	NO.	ISSUED FOR BID	01.31.23
	1		

SCALE: 1/8"=1'-0"
 DRAWN BY: _____
 CHECKED BY: _____
 PROJ. NO.: 22100


A-1.1 OF SHEET

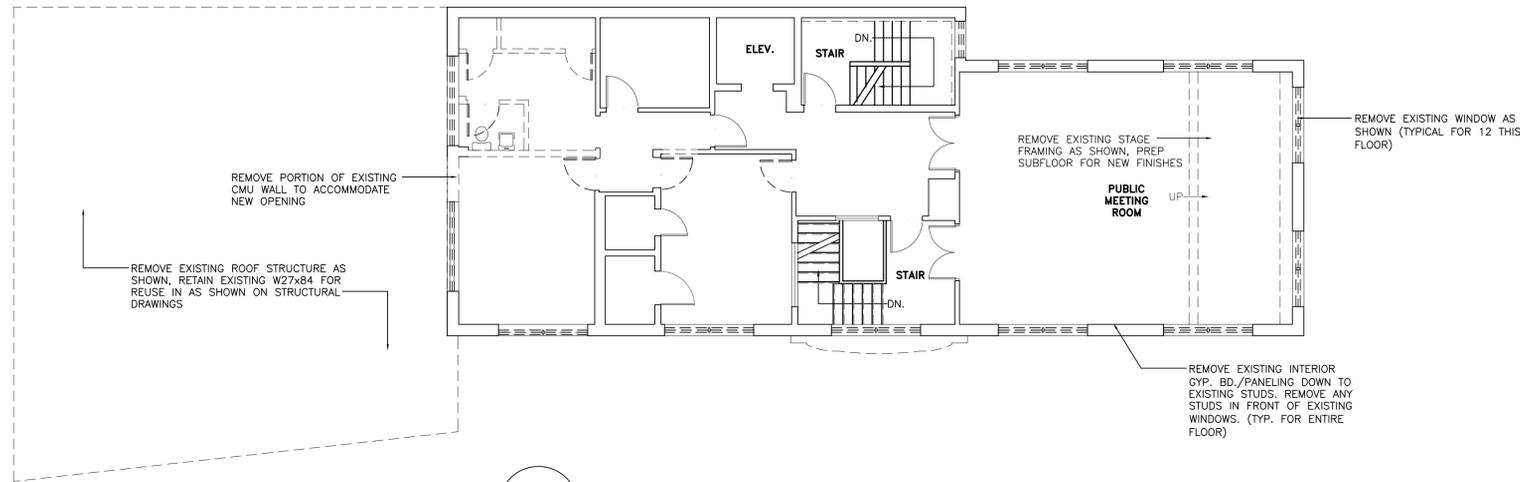

3 SECOND FLOOR DEMOLITION PLAN
D-1 SCALE: 1/8"=1'-0"

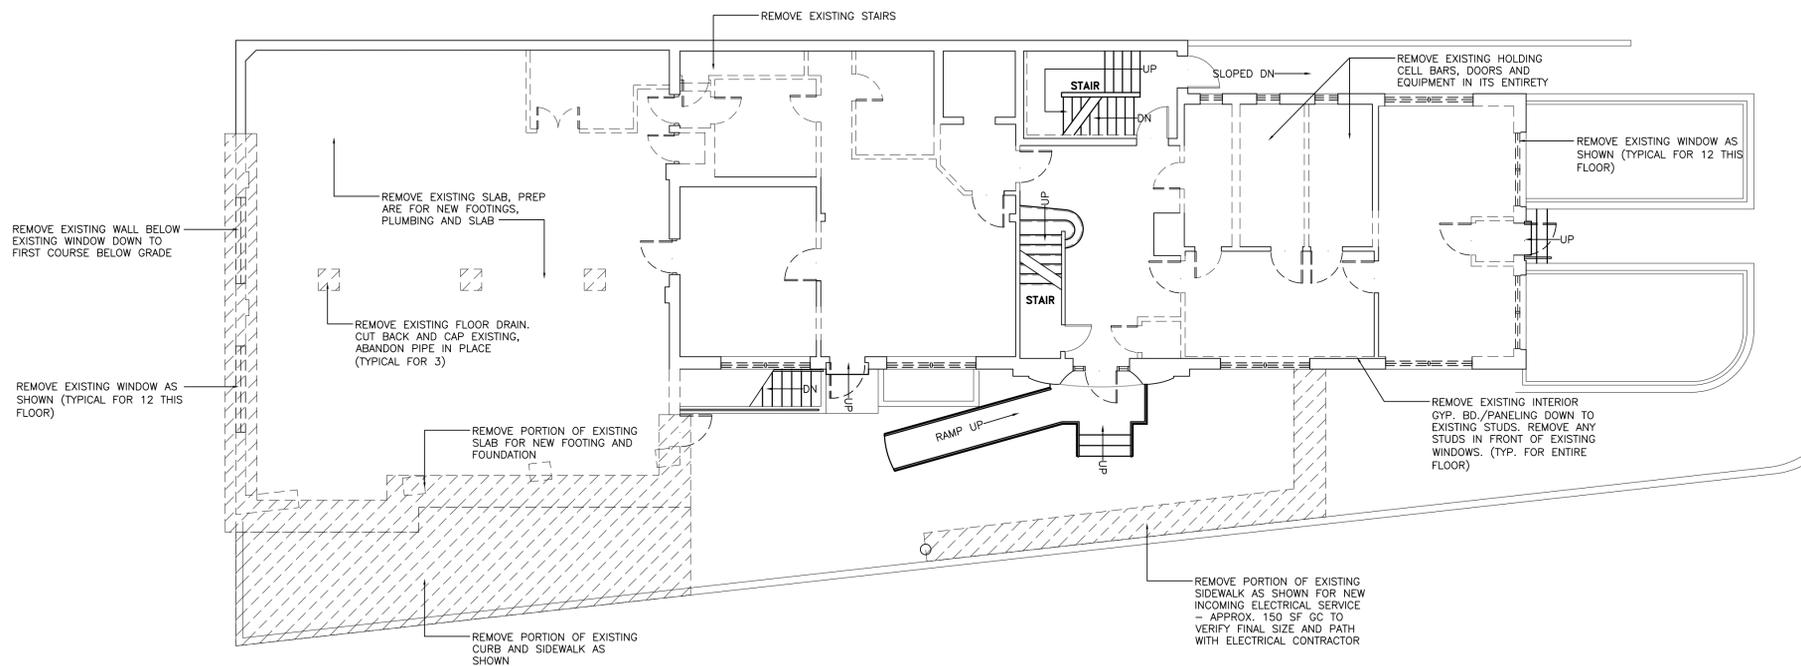

2 FIRST FLOOR DEMOLITION PLAN
D-1 SCALE: 1/8"=1'-0"

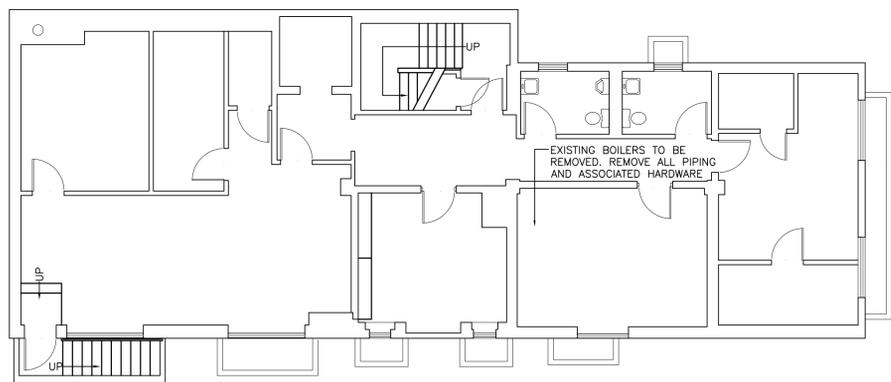

1 BASEMENT DEMOLITION PLAN
D-1 SCALE: 1/8"=1'-0"

NOTE: SCRAPE & PAINT ALL EXISTING EXPOSED STEEL CHANNELS REMAINING. COLOR TO BE WHITE.

NOTE: CLEAN, SCRAPE & POWERWASH EXISTING BRICK, PATCH & REPAIR ANY MISSING OR DAMAGED BRICK. REPOINT ALL REMAINING EXPOSED BRICK.

DEMO NOTES:

- 1) REMOVE ALL LIGHTS, RECEPTACLES, SWITCH PANELS, WIRING.
- 2) REMOVE ALL CONDUITS, PIPING, SUPPORTS AND ALL FIXTURES.
- 3) REMOVE ALL WALLS & DOORS AS SHOWN.
- 4) REMOVE ALL EXISTING MECHANICAL DEVICES, UNIT HEATERS, AC UNITS & ALL ASSOCIATED WIRING & PIPING.
- 5) REMOVE EXISTING BOILER AND ALL EXISTING RADIATORS, PIPING, VALVES AND ALL ASSOCIATED HARDWARE IN THERE ENTIRETY.
- 6) REMOVE ALL EXISTING PLUMBING FIXTURES, SUPPLY LINES & SANITARY PIPING. CUTBACK CAP & ABANDON ANY PIPING NOT BE REUSED. REMOVE ANY PIPING THAT CONFLICTS WITH NEW CONSTRUCTION.
- 7) REMOVE & DISPOSE OF ALL DEBRIS IN A LEGAL MANNER.
- 8) ALL CONTRACTORS SHALL KEEP THE SITE & BUILDING BROOM CLEAN ON A DAILY BASIS.

LINN ARCHITECTS
ARCHITECTURE
ENGINEERING
SITE PLANNING
INTERIOR DESIGN

140 N. PROVIDENCE ROAD
MEDIA, PENNSYLVANIA 19063
TEL: 610-566-7044
FAX: 610-566-3258

PROPOSED DEMOLITION PLANS
RENOVATIONS TO MUNICIPAL BUILDING
BOROUGH OF EDDYSTONE
1300 E. 12TH ST.
EDDYSTONE, PA 19022

DATE	REVISIONS	DESCRIPTION	DATE
01.31.23	NO.	ISSUED FOR BID	01.31.23
	1		

SHEET NO. **D-1** OF

DATE: 01.31.23
SCALE: 1/8"=1'-0"
DRAWN BY:
CHECKED BY:
PROJ. NO.: 22100